

THIS IS A TWO-SIDED DOCUMENT



**Adirondack
Park Agency**

PO Box 99 · 1133 NYS Route 86
Ray Brook, NY 12977
Tel: (518) 891-4050
www.apa.ny.gov

**APA General
Permit/Order
2024G-1**

Permit #: 2024-0298

**Certificate for Certain Minor
Regulated Activities in APA
Jurisdictional Freshwater Wetlands**

This certificate under General Permit 2024G-1 is granted to New York State Department of Environmental Conservation, authorizing a minor regulated activity in a freshwater wetland pursuant to the Freshwater Wetlands Act (Environmental Conservation Law, Article 24) and the Adirondack Park Agency Act (Executive Law, Article 27, including Section 809(13)(e)), in an area classified Wild Forest by the Official Adirondack Park Land Use and Development Plan as described in the application received by the Agency on October 28, 2024, and as depicted on the attached reduced-scale Project Plans. The project site is in the Town of Long Lake, Hamilton County.

The project shall not be undertaken or continued unless the project authorized herein, including site restoration and any required compensatory wetland mitigation, is completed within four years of the date of issuance of this certification.

This certificate does not convey any right to trespass upon the lands or interfere with the riparian rights of others in order to undertake the authorized project, nor does it authorize the impairment of any easement, right, title, or interest in real or personal property.

Nothing contained in this certificate shall be construed to satisfy any legal obligations of the permittee to comply with all applicable laws and regulations or to obtain any governmental approval or permit from any entity other than the Agency, whether federal, state, regional, or local.

Failure to comply with this general permit and approved attached Project Plans is a violation and may subject the project sponsor, successors and assigns to civil penalties and other legal proceedings, including modification, suspension or revocation of the permit.

PROJECT SITE

The project site is the Lake Eaton Campground located in the Town of Long Lake, Hamilton County, in an area classified Intensive Use on the Adirondack Park Land Use and Development Plan Map. The site is identified as Tax Map Section 25.000, Block 1, Parcel 15.

The project site contains deciduous forested and wet meadow wetlands associated with an unnamed tributary to Lake Eaton. Additional wetlands not described herein or depicted on the Project Plans may be located on or adjacent to the project site.

PROJECT DESCRIPTION AS PROPOSED

The project as conditionally approved herein involves replacement of three existing 18" culverts with two 28-inch wide by 20-inch deep galvanized steel arch style culverts. The project involves 22 square feet of temporary wetland fill associated with the installation of temporary erosion and sediment control and dewatering infrastructure.

The project is shown on a three-page set of plans titled "Lake Eaton Campground Culvert Replacement," prepared by The New York State Department of Environmental Conservation, and dated January 2025 (Project Plans).

A reduced-scale copy of the Project Plans for the project is attached to this certificate for easy reference. The original, full-scale maps and plans described in this paragraph are the official plans for the project, with copies available upon request from Adirondack Park Agency headquarters in Ray Brook, New York.

CONDITIONS

1. This permit is binding on the permittee(s) and all contractors undertaking all or a portion of the project authorized herein. Copies of this certificate and Project Plans shall be furnished by the permittee to all contractors prior to undertaking the activities authorized herein.
2. This certificate authorizes minor regulated activities in a freshwater wetland as depicted and described in the Project Plans. Any change to the location, dimensions, materials, or other aspect of the activities authorized herein shall require prior written Agency authorization.
3. Prior to construction, including clearing and grubbing, temporary erosion and sediment control measures shall be installed and maintained as depicted and described in the Project Plans. All silt fence shall be properly installed with the bottom buried at a depth of at least 4 inches. Once the site has been stabilized, silt fence and any other temporary erosion and sediment controls shall be completely removed.
4. All site restoration activities depicted and described in the Project Plans shall be implemented within three days of project completion, and in accordance with the approved implementation schedule.
5. The permittee shall notify the Agency in writing within five business days after the work authorized by this certificate, including any required restoration of temporary wetland impacts, has been successfully completed. Written notification shall include color photographs which clearly show the completed work and site restoration and identify the date and location that the photographs were taken.
6. The authorized work shall be scheduled and conducted during drier periods (not during major storm events, spring runoff, and thawing conditions) to avoid and minimize erosion of soils and to prevent silting and muddying of wetlands or surface waterbodies.

7. No mechanized equipment shall be driven in wetlands unless expressly authorized herein. Every effort shall be made to work from upland areas and to minimize disturbances to areas adjacent to wetlands. Only tracked equipment shall be used in wetlands. Vehicular access in wetlands shall be under frozen conditions when possible.
8. Wetland disturbance including grading and grubbing of stumps and roots shall be limited to the area depicted and described on the Project Plans.
9. No waste disposal, material or excavation stockpiling, or dewatering discharge shall occur in or within 100 feet of wetlands unless specifically authorized in the Project Plans. Clean water bypass shall be discharged in a manner that limits or prevents erosion, sedimentation, and particle suspension.
10. When brought from off-site, all equipment, including but not limited to trucks, excavators, tractors, etc., and hand excavation tools such as shovels, rakes, and picks, to be used on the project site shall be clean and free of soil, mud, or other similar material. If washed on the project site, equipment shall be washed in one location to prevent the distribution of propagules among different wash sites. All construction equipment and vehicles operating in areas that may contain existing invasive species shall be thoroughly cleaned prior to moving to other areas.
11. Any cutting of vegetation along the shorelines of navigable waterbodies shall be in conformance with the Shoreline Restrictions of Section 806 of the Adirondack Park Agency Act. A copy of the Shoreline Restrictions or the Citizen's Guide is available upon request.
12. All tree cutting and/or vegetation removal shall be limited to the area depicted and described on the Project Plans. All cut vegetation shall be immediately removed from the wetland and adjacent area upon completion of the activity.
13. Existing pipe and box culverts shall be replaced at their existing location unless structure re-location or re-alignment is specifically authorized herein. Replacement culverts and any associated scour protection must be installed so that they do not constitute a barrier to upstream movement of fish and other aquatic species.
14. All culverts with closed bottoms (including round culvert pipes) must be appropriately embedded. Round culverts must be installed with at least 20% of the culverts vertical height is embedded below the existing wetland substrate.
15. Native soil material or wetland substrate shall be placed for culvert embedding and spread evenly throughout the bottom of the new culvert where appropriate.
16. New or replacement culverts shall be installed so as to preserve the pre-construction water levels unless specifically authorized herein and shall not inhibit the natural movement of fish or other aquatic species.
17. Water control structures shall be of the type and size, and shall be placed in such a manner so as to not impair surface water flow into or out of the wetland.

18. Water control structures shall be constructed of non-erodible materials, and located in such a manner so as to prevent its dispersion or movement by normal or high water flows.

CERTIFICATE issued this 30th day
of January, 2025.

ADIRONDACK PARK AGENCY

BY: Ariel Lynch
Ariel Lynch
Environmental Program Specialist 3 (EPS3)

STATE OF NEW YORK
COUNTY OF ESSEX


On the 30th day of January in the year 2025, before me, the undersigned, a Notary Public in and for said State, personally appeared Ariel Lynch, personally known to me or proved to me on the basis of satisfactory evidence to be the individual whose name is subscribed to the within instrument and acknowledged to me that they executed the same in their capacity, and that by their signature on the instrument, the individual, or the person upon behalf of which the individual acted, executed the instrument.

Stephanie L. Petith
Notary Public

Stephanie L. Petith
Notary Public, State of New York
Reg No 01PE6279890
Qualified in Franklin County
Commission Expires April 15, 2025

LAKE EATON CAMPGROUND CULVERT REPLACEMENT

TOWN OF LONG LAKE * COUNTY OF HAMILTON * STATE OF NEW YORK

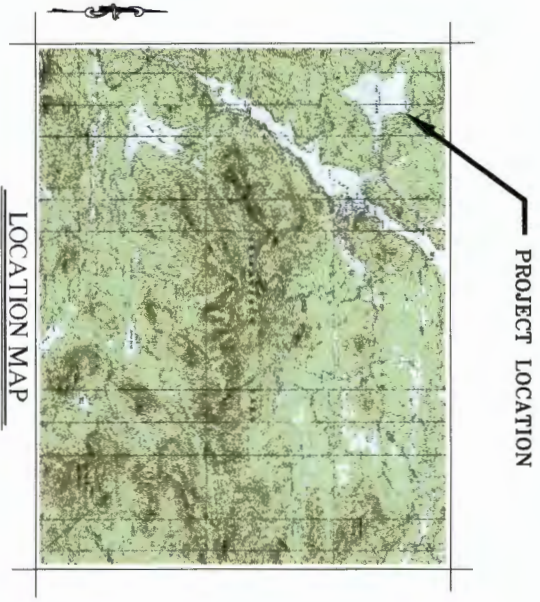

INDEX

- T1 TITLE SHEET
- C1 APA WETLAND PROTECTION SITE PLAN - DOWNSTREAM
- C2 APA WETLAND PROTECTION SITE PLAN - UPSTREAM




**Department of
Environmental
Conservation**


PROJECT DESCRIPTION LAKE EATON CAMPGROUND CULVERT REPLACEMENT TITLE SHEET	RECOMMENDED FOR APPROVAL BY: DATE _____ PROJECT ENGINEER BUREAU OF DESIGN AND CONSTRUCTION DATE _____ CHIEF BUREAU OF DESIGN AND CONSTRUCTION DATE _____ DIRECTOR DIVISION OF OPERATIONS	Department of Environmental Conservation DIVISION OF OPERATIONS BUREAU OF MAINTENANCE AND TECHNICAL SERVICES
	FACILITY NAME LAKE EATON CAMPGROUND FACILITY NO. 0019 PROJECT NO. 5-2413 DATE JAN. 25 SCALE AS NOTED DRAWING NO. T1	

1. THE CONTRACTOR SHALL MAINTAIN OPEN TO AIR DRAINAGE OF EXISTING CULVERTS PRIOR TO REMOVAL.
2. WHEN REMOVED, ALL EXISTING CULVERTS SHALL BE REMOVED TO A MINIMUM OF 10 FEET FROM THE EXISTING CULVERT.
3. ALL EXISTING CULVERTS SHALL BE REMOVED TO A MINIMUM OF 10 FEET FROM THE EXISTING CULVERT.
4. ALL EXISTING CULVERTS SHALL BE REMOVED TO A MINIMUM OF 10 FEET FROM THE EXISTING CULVERT.
5. ALL EXISTING CULVERTS SHALL BE REMOVED TO A MINIMUM OF 10 FEET FROM THE EXISTING CULVERT.
6. ALL EXISTING CULVERTS SHALL BE REMOVED TO A MINIMUM OF 10 FEET FROM THE EXISTING CULVERT.
7. ALL EXISTING CULVERTS SHALL BE REMOVED TO A MINIMUM OF 10 FEET FROM THE EXISTING CULVERT.


NEW YORK STATE OF OPPORTUNITY
Adirondack Park Agency
FINAL
P2024-0298

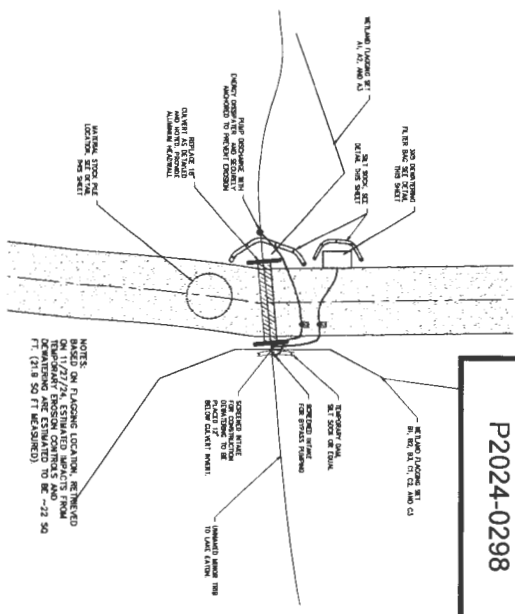


CULVERT REPLACEMENT PLAN
 SCALE: 1" = 10'

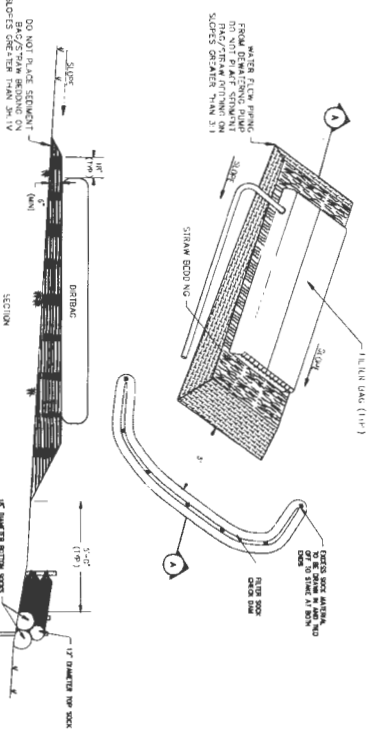

1 DEWATERING PROTECTION DETAIL
 SCALE: N.T.S.

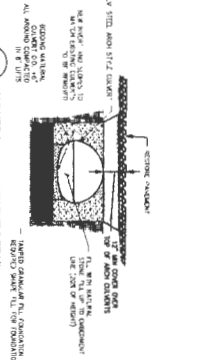


2 CULVERT REPLACEMENT DETAIL
 SCALE: N.T.S.

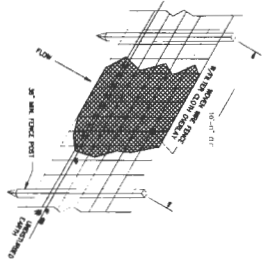

3 FILTER SOCK DETAIL
 SCALE: N.T.S.

4 SILT FENCE DETAILS
 SCALE: N.T.S.

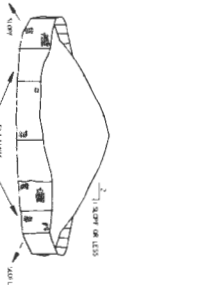


5 SOIL MATERIAL STOCKPILE DETAIL
 SCALE: N.T.S.

PROJECT DESCRIPTION LAKE EATON CAMPGROUND CULVERT REPLACEMENT APA WETLAND PROTECTION SITE PLAN - DOWNSTREAM		REVISIONS <table border="1"> <thead> <tr> <th>NO.</th> <th>DATE</th> <th>DESCRIPTION</th> <th>BY</th> </tr> </thead> <tbody> <tr> <td>1</td> <td></td> <td>AS BUILT</td> <td></td> </tr> </tbody> </table>		NO.	DATE	DESCRIPTION	BY	1		AS BUILT		DESIGNED BY: _____ CHECKED BY: _____ DRAWN BY: _____		Department of Environmental Conservation DIVISION OF OPERATIONS BUREAU OF MAINTENANCE AND TECHNICAL SERVICES	
NO.	DATE	DESCRIPTION	BY												
1		AS BUILT													
PROPERTY STATE LAKE EATON CAMPGROUND FACILITY NO. 0319 PROJECT NO. 5-2413 DATE JAN. 25 SCALE AS NOTED DRAWING NO. C1															

1. THE CONTRACTOR SHALL MAINTAIN THE EXISTING AND PROPOSED CULVERTS OPEN TO TRAFFIC THROUGHOUT THE CONSTRUCTION PERIOD.
2. THE CONTRACTOR SHALL MAINTAIN THE EXISTING AND PROPOSED CULVERTS OPEN TO TRAFFIC THROUGHOUT THE CONSTRUCTION PERIOD.
3. THE CONTRACTOR SHALL MAINTAIN THE EXISTING AND PROPOSED CULVERTS OPEN TO TRAFFIC THROUGHOUT THE CONSTRUCTION PERIOD.
4. THE CONTRACTOR SHALL MAINTAIN THE EXISTING AND PROPOSED CULVERTS OPEN TO TRAFFIC THROUGHOUT THE CONSTRUCTION PERIOD.
5. THE CONTRACTOR SHALL MAINTAIN THE EXISTING AND PROPOSED CULVERTS OPEN TO TRAFFIC THROUGHOUT THE CONSTRUCTION PERIOD.
6. THE CONTRACTOR SHALL MAINTAIN THE EXISTING AND PROPOSED CULVERTS OPEN TO TRAFFIC THROUGHOUT THE CONSTRUCTION PERIOD.
7. THE CONTRACTOR SHALL MAINTAIN THE EXISTING AND PROPOSED CULVERTS OPEN TO TRAFFIC THROUGHOUT THE CONSTRUCTION PERIOD.


NEW YORK
STATE OF
ADIRONDACK
PARK AGENCY

FINAL
P2024-0298

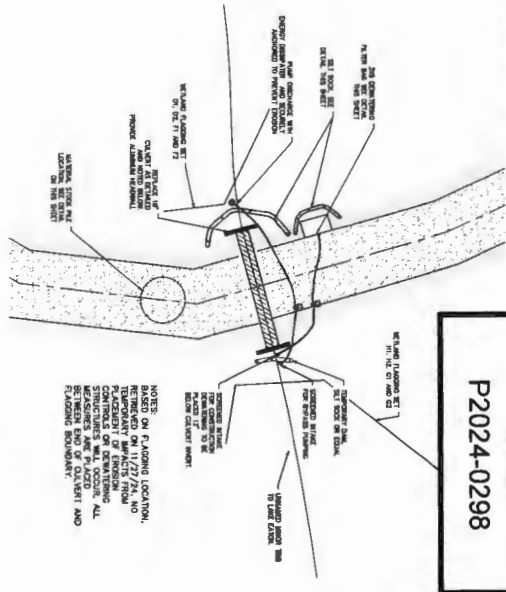


CULVERT REPLACEMENT PLAN
SCALE: 1" = 10'


1 DEWATERING PROTECTION DETAIL
SCALE: N/A

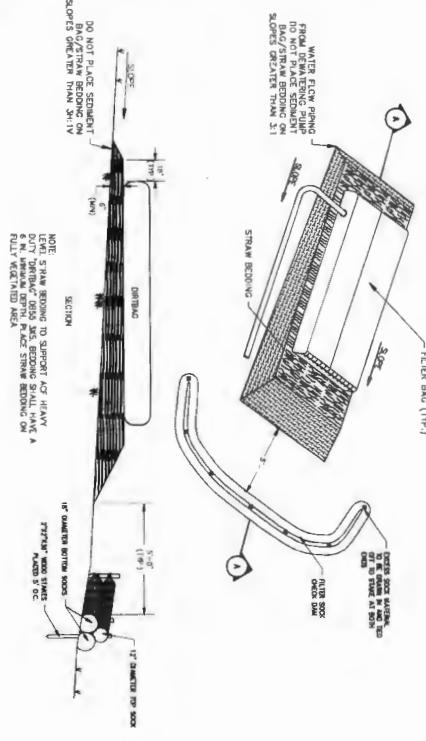



2 CULVERT REPLACEMENT DETAIL
SCALE: N/A

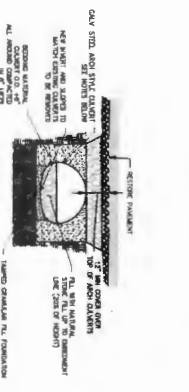



3 FILTER BAG DETAIL
SCALE: N/A

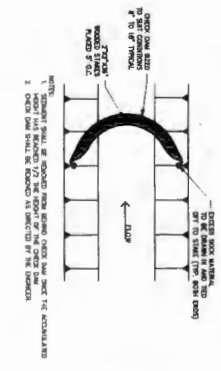

4 SILT FENCE DETAILS
SCALE: N/A

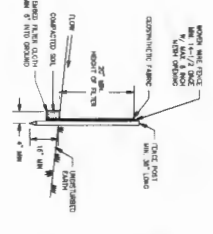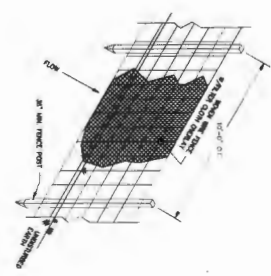

5 SOIL/WATERBAG STOCKPILE DETAIL
SCALE: N/A

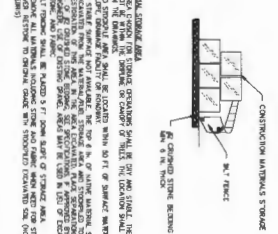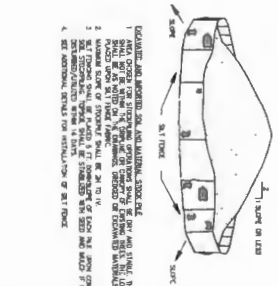

<p>PROJECT DESCRIPTION</p> <p>LAKE EATON CAMPGROUND CULVERT REPLACEMENT</p> <p>APA WETLAND PROTECTION SITE PLAN- UPSTREAM</p>		<p>REVISIONS</p> <table border="1"> <thead> <tr> <th>NO</th> <th>DATE</th> <th>DESCRIPTION</th> <th>BY</th> </tr> </thead> <tbody> <tr> <td>AS BUILT</td> <td></td> <td></td> <td></td> </tr> </tbody> </table>		NO	DATE	DESCRIPTION	BY	AS BUILT				<p>DESIGNED BY</p> <p>CHECKED BY</p> <p>DRAWN BY</p>		<p>NEW YORK STATE OF ADIRONDACK PARK AGENCY</p> <p>Department of Environmental Conservation</p> <p>DIVISION OF OPERATIONS BUREAU OF MAINTENANCE AND TECHNICAL SERVICES</p>
NO	DATE	DESCRIPTION	BY											
AS BUILT														
<p>FACILITY NAME</p> <p>LAKE EATON CAMPGROUND</p> <p>PROJECT NO.</p> <p>5-2413</p> <p>DATE</p> <p>JAN. 25</p> <p>SCALE</p> <p>AS NOTED</p> <p>DRAWING NO.</p> <p>C2</p>		<p>NO. DATE DESCRIPTION BY</p>		<p>DESIGNED BY</p> <p>CHECKED BY</p> <p>DRAWN BY</p>										