

THIS IS A TWO-SIDED DOCUMENT



**Adirondack
Park Agency**

PO Box 99 · 1133 NYS Route 86
Ray Brook, NY 12977
Tel: (518) 891-4050
www.apa.ny.gov

**APA General
Permit/Order
2024G-1**

Permit #: 2026-0052

**Certificate for Certain Minor
Regulated Activities in APA
Jurisdictional Freshwater
Wetlands**

This certificate under General Permit 2024G-1 is granted to the New York State Department of Transportation, authorizing a minor regulated activity in a freshwater wetland pursuant to the Freshwater Wetlands Act (Environmental Conservation Law, Article 24) and the Adirondack Park Agency Act (Executive Law, Article 27, including Section 809(13)(e)), in an area classified Wild Forest and Wilderness by the Official Adirondack Park Land Use and Development Plan as described in the application received by the Agency on March 11, 2026 and as depicted on the attached reduced-scale Project Plans. The project site is in the Town of Indian Lake, Hamilton County.

The project shall not be undertaken or continued unless the project authorized herein, including site restoration, is completed within four years of the date of issuance of this certification.

This certificate does not convey any right to trespass upon the lands or interfere with the riparian rights of others in order to undertake the authorized project, nor does it authorize the impairment of any easement, right, title, or interest in real or personal property.

Nothing contained in this certificate shall be construed to satisfy any legal obligations of the permittee to comply with all applicable laws and regulations or to obtain any governmental approval or permit from any entity other than the Agency, whether federal, state, regional, or local.

Failure to comply with this general permit and approved attached Project Plans is a violation and may subject the project sponsor, successors and assigns to civil penalties and other legal proceedings, including modification, suspension or revocation of the permit.

PROJECT SITE

The project site is located within the transportation right-of-way of State Route 28 in the Town of Indian Lake, Hamilton County, in an area classified Wild Forest and Wilderness on the Adirondack Park Land Use and Development Plan Map. The site is adjacent to Tax Map Section 47.000, Block 1, Parcel 22.

The project site contains wetlands associated with Johnny Mack Brook.

PROJECT DESCRIPTION AS PROPOSED

The project as conditionally approved herein involves:

- The replacement of an existing culvert with a 54-inch by 96.75-inch by 98.75-foot smooth-interior, corrugated polyethylene pipe to be embedded 10.8 inches with native streambed material; and
- The installation of steel safety end sections and stone aprons on either end of the new culvert.

The project is shown on the following Project Plans:

- A two-page, annotated plan set depicting temporary and permanent wetland impacts, titled "Erosion Control Plan" and "Plan Sheet RM 28 2209 1322", prepared by the New York State Department of Transportation, received by the Agency on May 11, 2026 ("Wetland Impact Plans"); and
- A two-page plan set titled, "Route 28 Culvert Replacement", prepared by the New York State Department of Transportation, dated March 10, 2026 and received by the Agency on March 11, 2026 ("Site Plans").

A reduced-scale copy of the Project Plans is attached to this certificate for easy reference. The original, full-scale maps and plans described in this paragraph are the official plans for the project, with copies available upon request from Adirondack Park Agency headquarters in Ray Brook, New York.

CONDITIONS

1. This permit is binding on the permittee and all contractors undertaking all or a portion of the project authorized herein. Copies of this certificate and Project Plans shall be furnished by the permittee to all contractors prior to undertaking the activities authorized herein.
2. This certificate authorizes minor regulated activities in a freshwater wetland as depicted and described in the Project Plans. Any change to the location, dimensions, materials, or other aspect of the activities authorized herein shall require prior written Agency authorization.
3. Prior to construction, including clearing and grubbing, temporary erosion and sediment control measures shall be installed and maintained as depicted and described in the Project Plans. All silt fence shall be properly installed with the bottom buried at a depth of at least 4 inches. Once the site has been stabilized, silt fence and any other temporary erosion and sediment controls shall be completely removed.
4. All site restoration activities depicted and described in the Project Plans shall be implemented within three days of project completion, and in accordance with the approved implementation schedule.

5. The permittee shall notify the Agency in writing within five business days after the work authorized by this certificate including any required restoration of temporary wetland impacts has been successfully completed. Written notification shall include color photographs which clearly show the completed work and site restoration and identify the date and location that the photographs were taken.
6. The authorized work shall be scheduled and conducted during drier periods (not during major storm events, spring runoff, and thawing conditions) to avoid and minimize erosion of soils and to prevent silting and muddying of wetlands or surface waterbodies.
7. No mechanized equipment shall be driven in wetlands unless expressly authorized herein. Every effort shall be made to work from upland areas and to minimize disturbances to areas adjacent to wetlands. Only tracked equipment shall be used in wetlands. Vehicular access in wetlands shall be under frozen conditions when possible. If work cannot be performed under frozen conditions, timber mats shall be used for access in wetlands, to be removed within three days of project completion and areas beneath timber mats restored to pre-construction condition. No temporary access structures shall be located within a wetland for more than 30 days.
8. Wetland disturbance including grading and grubbing of stumps and roots shall be limited to the area depicted and described on the Project Plans.
9. No waste disposal, material or excavation stockpiling, or dewatering discharge shall occur in or within 100 feet of wetlands unless specifically authorized in the Project Plans. Clean water bypass shall be discharged back to freshwater wetlands in a manner that limits or prevents erosion, sedimentation, and particle suspension.
10. When brought from off-site, all equipment, including but not limited to trucks, excavators, tractors, etc., and hand excavation tools such as shovels, rakes, and picks, to be used on the project site shall be clean and free of soil, mud, or other similar material. If washed on the project site, equipment shall be washed in one location to prevent the distribution of propagules among different wash sites. All construction equipment and vehicles operating in areas that may contain existing invasive species shall be thoroughly cleaned prior to moving to other areas.
11. Any cutting of vegetation along the shorelines of navigable waterbodies shall be in conformance with the Shoreline Restrictions of Section 806 of the Adirondack Park Agency Act. A copy of the Shoreline Restrictions or the Citizen's Guide is available upon request.
12. All tree cutting and/or vegetation removal shall be limited to the area depicted and described on the Project Plans. All cut vegetation shall be immediately removed from the wetland and adjacent area upon completion of the activity.
13. Existing pipe and box culverts shall be replaced at their existing location unless structure re-location or re-alignment is specifically authorized herein.

Replacement culverts and any associated scour protection must be installed so that they do not constitute a barrier to upstream movement of fish and other aquatic species.


14. All culverts with closed bottoms (including round culvert pipes) must be appropriately embedded. Round culverts must be installed with at least 20% of the culverts vertical height is embedded below the existing wetland substrate.
15. Native soil material or wetland substrate shall be placed for culvert embedding and spread evenly throughout the bottom of the new culvert where appropriate.
16. New or replacement culverts shall be installed so as to preserve the pre-construction water levels unless specifically authorized herein and shall not inhibit the natural movement of fish or other aquatic species.
17. Any fills required for temporary construction access, detour and work pad facilities shall be of clean, heavy stone fill or other non-erodible material placed on geo-textile fabric up to the mean high water elevation.
18. Temporary construction access, detour and work pad facilities (including necessary fills) shall be located so as to avoid or minimize disturbance of the wetland, and appropriate temporary drainage measures must be taken to maintain pre-construction water flows and water table characteristics.
19. Water control structures shall be of the type and size, and shall be placed in such a manner, so as to not impair surface water flow into or out of the wetland.
20. Water control structures shall be constructed of non-erodible materials, and located in such a manner so as to prevent its dispersion or movement by normal or high water flows.
21. Temporary construction access, detour, and work pad facilities (including necessary fills) shall be entirely removed following completion of construction activities, and the affected and adjacent area successfully restored to its pre-construction condition, including replacement planting of native trees and shrubs.

Dated: June 4th, 2026

Ray Brook, New York

ADIRONDACK PARK AGENCY

By:

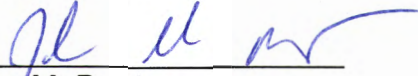

John M. Burth


Deputy Director, Regulatory Programs

STATE OF NEW YORK
COUNTY OF ESSEX

On the 4th day of June in the year 2026, before me, the undersigned, a Notary Public in and for said State personally appeared John M. Burth, personally known to me or proved to me on the basis of satisfactory evidence to be the individual whose name is subscribed to the within instrument and acknowledged to me that they executed the same in their capacity, and that by their signature on the instrument, the individual, or the person upon behalf of which the individual acted, executed the instrument.

Stephanie L. Petith
Notary Public

STEPHANIE PETITH
Notary Public, State of New York
Reg. No. 01PE6279890
Qualified in Essex County
Commission Expires April 15, 2029

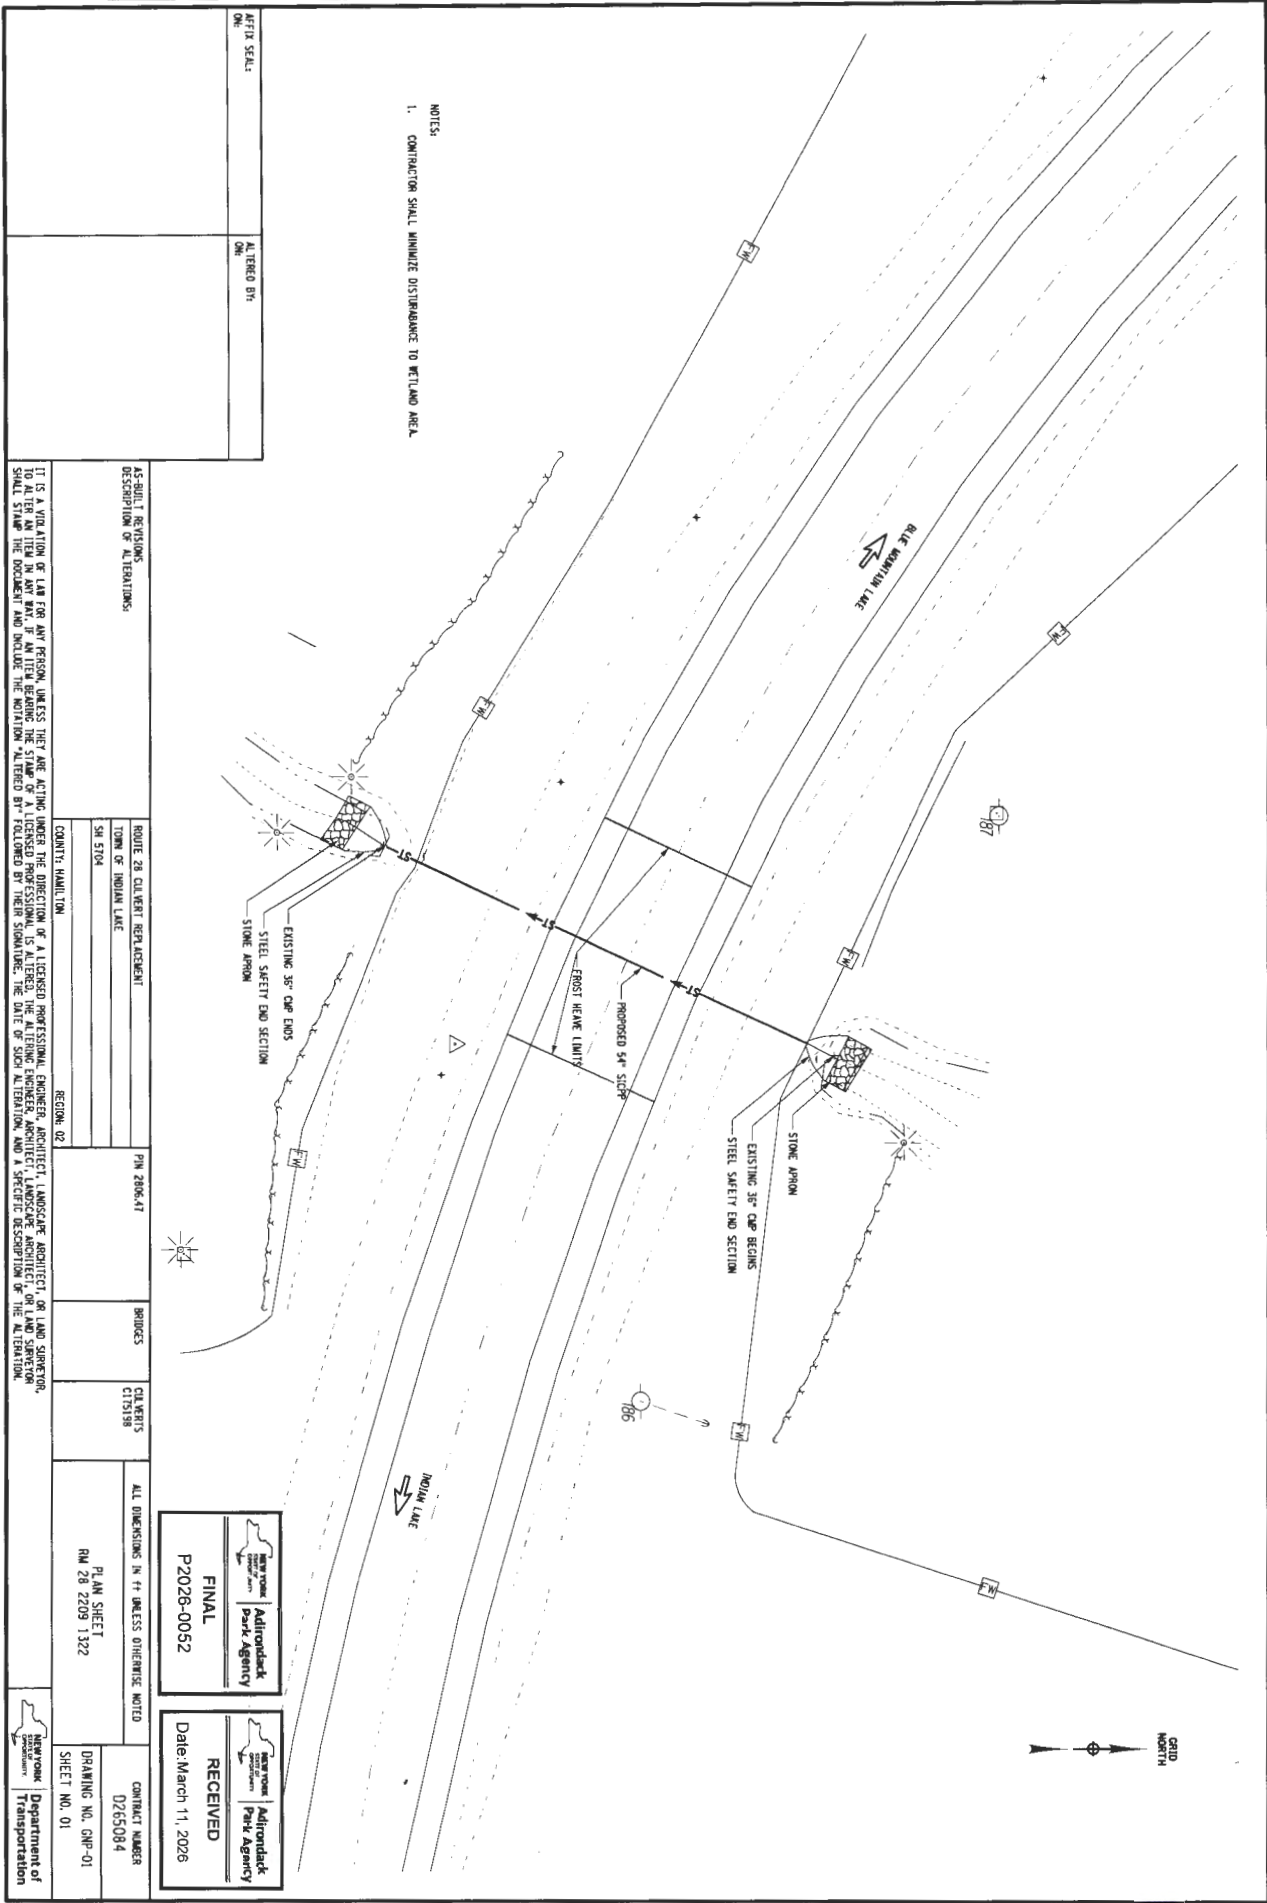

NOTES
 1. CONTRACTOR SHALL MINIMIZE DISTURBANCE TO WETLAND AREA.

ALTERED BY:	ALTERED BY:
DATE:	DATE:

AS-BUILT REVISIONS	ROUTE 28 CULVERT REPLACEMENT	PIN 2806.47	BRIDGES	CULVERTS	ALL DIMENSIONS IN FT UNLESS OTHERWISE NOTED	CONTRACT NUMBER
DESCRIPTION OF ALTERATIONS:	TOWN OF INDIAN LAKE			CITY 139		0265084
	SR 504					DRAWING NO. CWP-01
						SHEET NO. 01

IT IS A VIOLATION OF LAW FOR ANY PERSON, UNLESS THEY ARE ACTING UNDER THE DIRECTION OF A LICENSED PROFESSIONAL ENGINEER, ARCHITECT, LANDSCAPE ARCHITECT, OR LAND SURVEYOR, TO ALTER ANY ITEM IN ANY WAY. IF AN ITEM BEARING THE STAMP OF A LICENSED PROFESSIONAL IS ALTERED, THE ALTERING PROFESSIONAL IS ALTERED. THE DATE OF SUCH ALTERATION AND A SPECIFIC DESCRIPTION OF THE ALTERATION SHALL STAMP THE DOCUMENT AND INCLUDE THE NOTATION "ALTERED BY" FOLLOWED BY THEIR SIGNATURE.

Adirondack Park Agency


FINAL

P2026-0052

Adirondack Park Agency

RECEIVED

Date: March 11, 2026

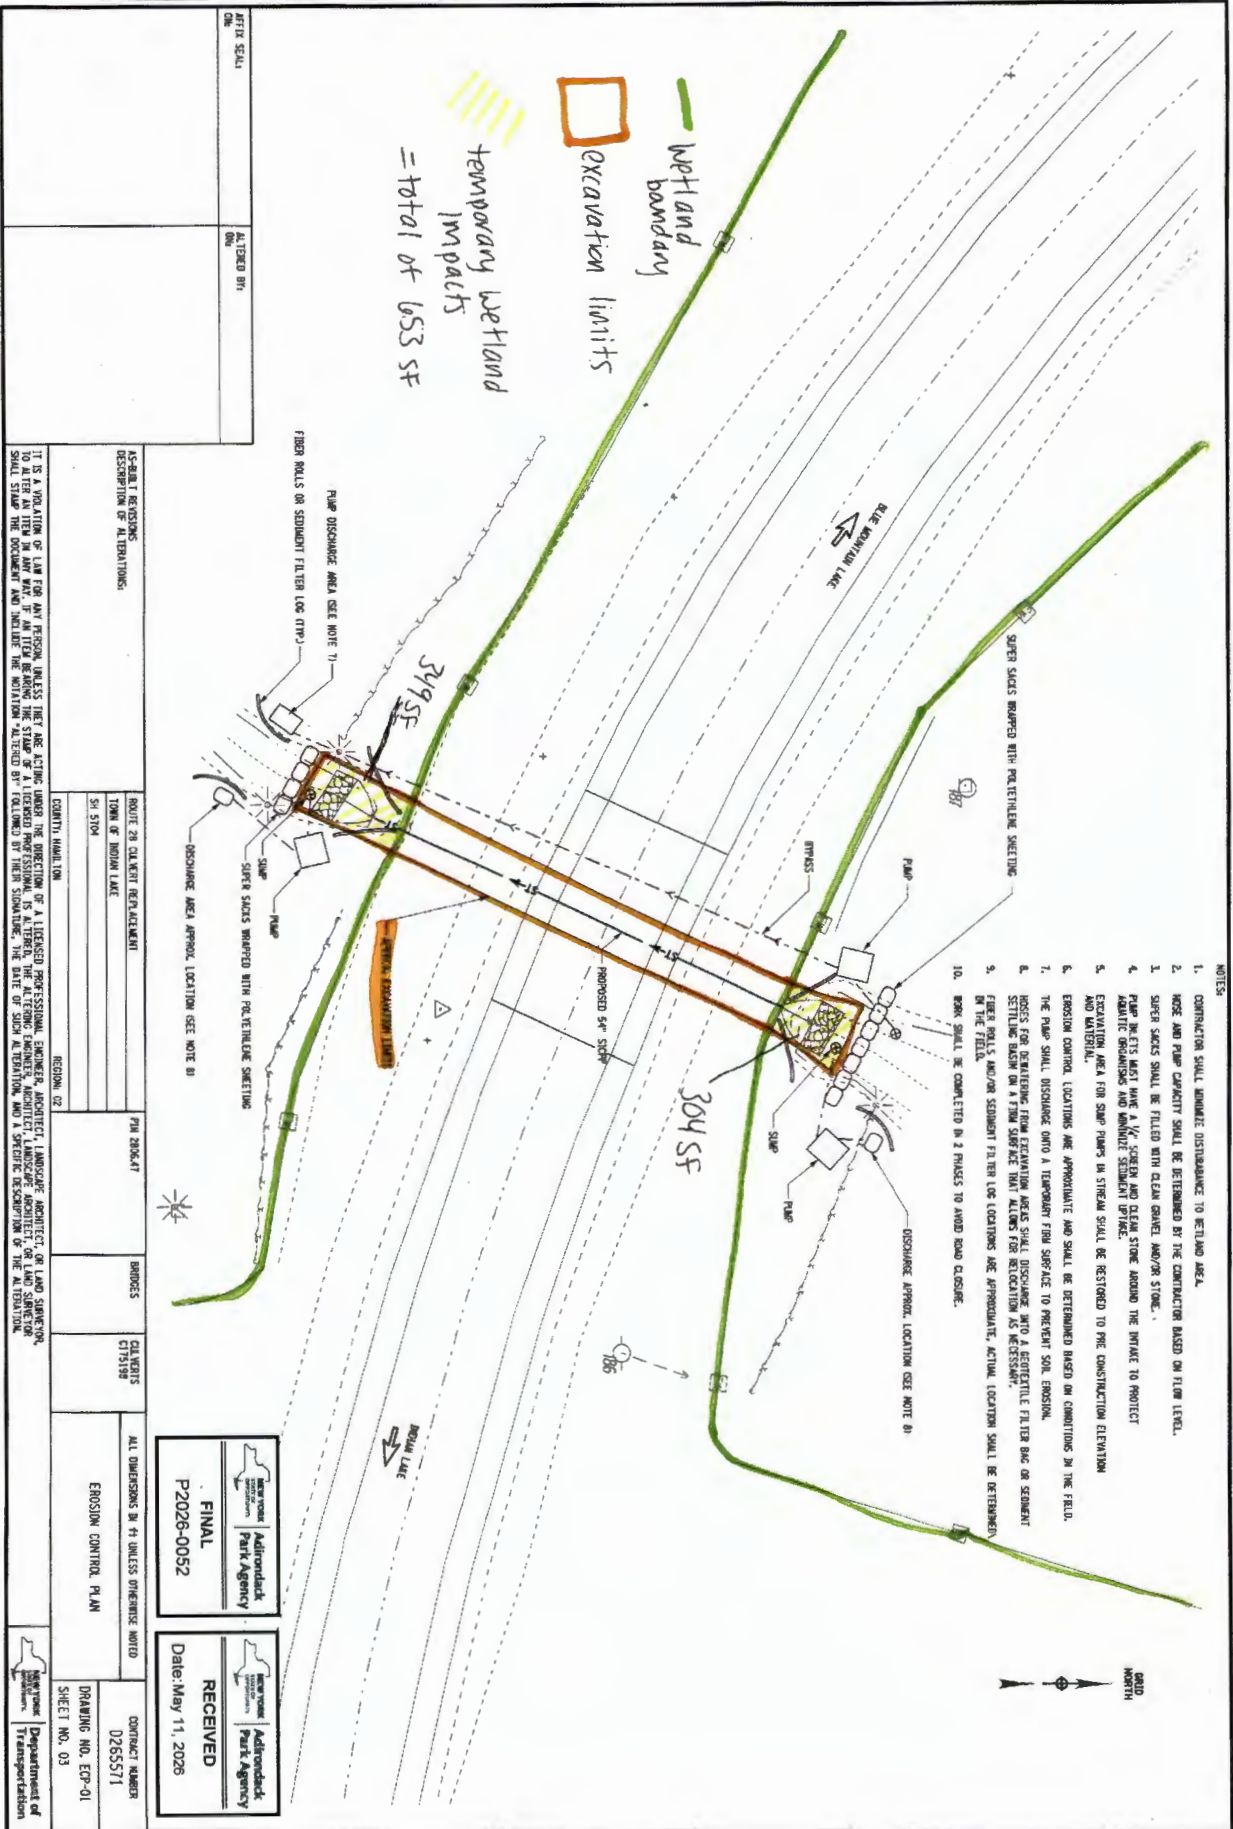


- NOTES:
1. CONTRACTOR SHALL MAINTAIN DISTANCE TO ETL AND AEL.
 2. HOES AND PUMP CAPACITY SHALL BE DETERMINED BY THE CONTRACTOR BASED ON FLOW LEVEL.
 3. SUPER SACKS SHALL BE FILLED WITH CLEAN GRAVEL AND/OR STONE.
 4. PUMP INLETS MUST HAVE A 1/2" SCREEN AND CLEAN STONE AROUND THE INTAKE TO PREVENT AQUATIC ORGANISMS AND UNWANTED SEDIMENT UPTAKE.
 5. EXCAVATION AREA FOR SHAP PUMPS IN STREAM SHALL BE RESTORED TO PRE CONSTRUCTION ELEVATION AND MATERIAL.
 6. EROSION CONTROL LOCATIONS ARE APPROXIMATE AND SHALL BE DETERMINED BASED ON CONDITIONS IN THE FIELD.
 7. THE PUMP SHALL DISCHARGE ONTO A TEMPORARY FIRM SURFACE TO PREVENT SOIL EROSION.
 8. HOES FOR DRAINING FROM EXCAVATION AREAS SHALL DISCHARGE INTO A GEOTEXTILE FILTER BAG OR SEDIMENT SETTLING BASIN ON A FIRM SURFACE THAT ALLOWS FOR RELOCATION AS NECESSARY.
 9. FIRM ROLLS AND/OR SEDIMENT FILTER LOG LOCATIONS ARE APPROXIMATE. ACTUAL LOCATION SHALL BE DETERMINED IN THE FIELD.
 10. WORK SHALL BE COMPLETED IN 2 PHASES TO AVOID ROAD CLOSURE.

AS-BUILT REVISIONS		ROUTE 29 CULTIVATED REPAIRMENT		PIN 2806.47		BRIDGES		ELEVATIONS		ALL DIMENSIONS IN FT UNLESS OTHERWISE NOTED		CONTRACT NUMBER	
DESCRIPTION OF ALTERATIONS		TOWN OF MOUNTAIN LAKE		SHEET 03		REGION 02		CITY/STATE		EROSION CONTROL PLAN		DRAWING NO. ECP-01	
COUNTY HAMILTON		TOWN OF MOUNTAIN LAKE		SHEET 03		REGION 02		CITY/STATE		EROSION CONTROL PLAN		DRAWING NO. ECP-01	

FINAL
P2026-0052

RECEIVED
Date: May 11, 2026

New York State
Adirondack Park Agency

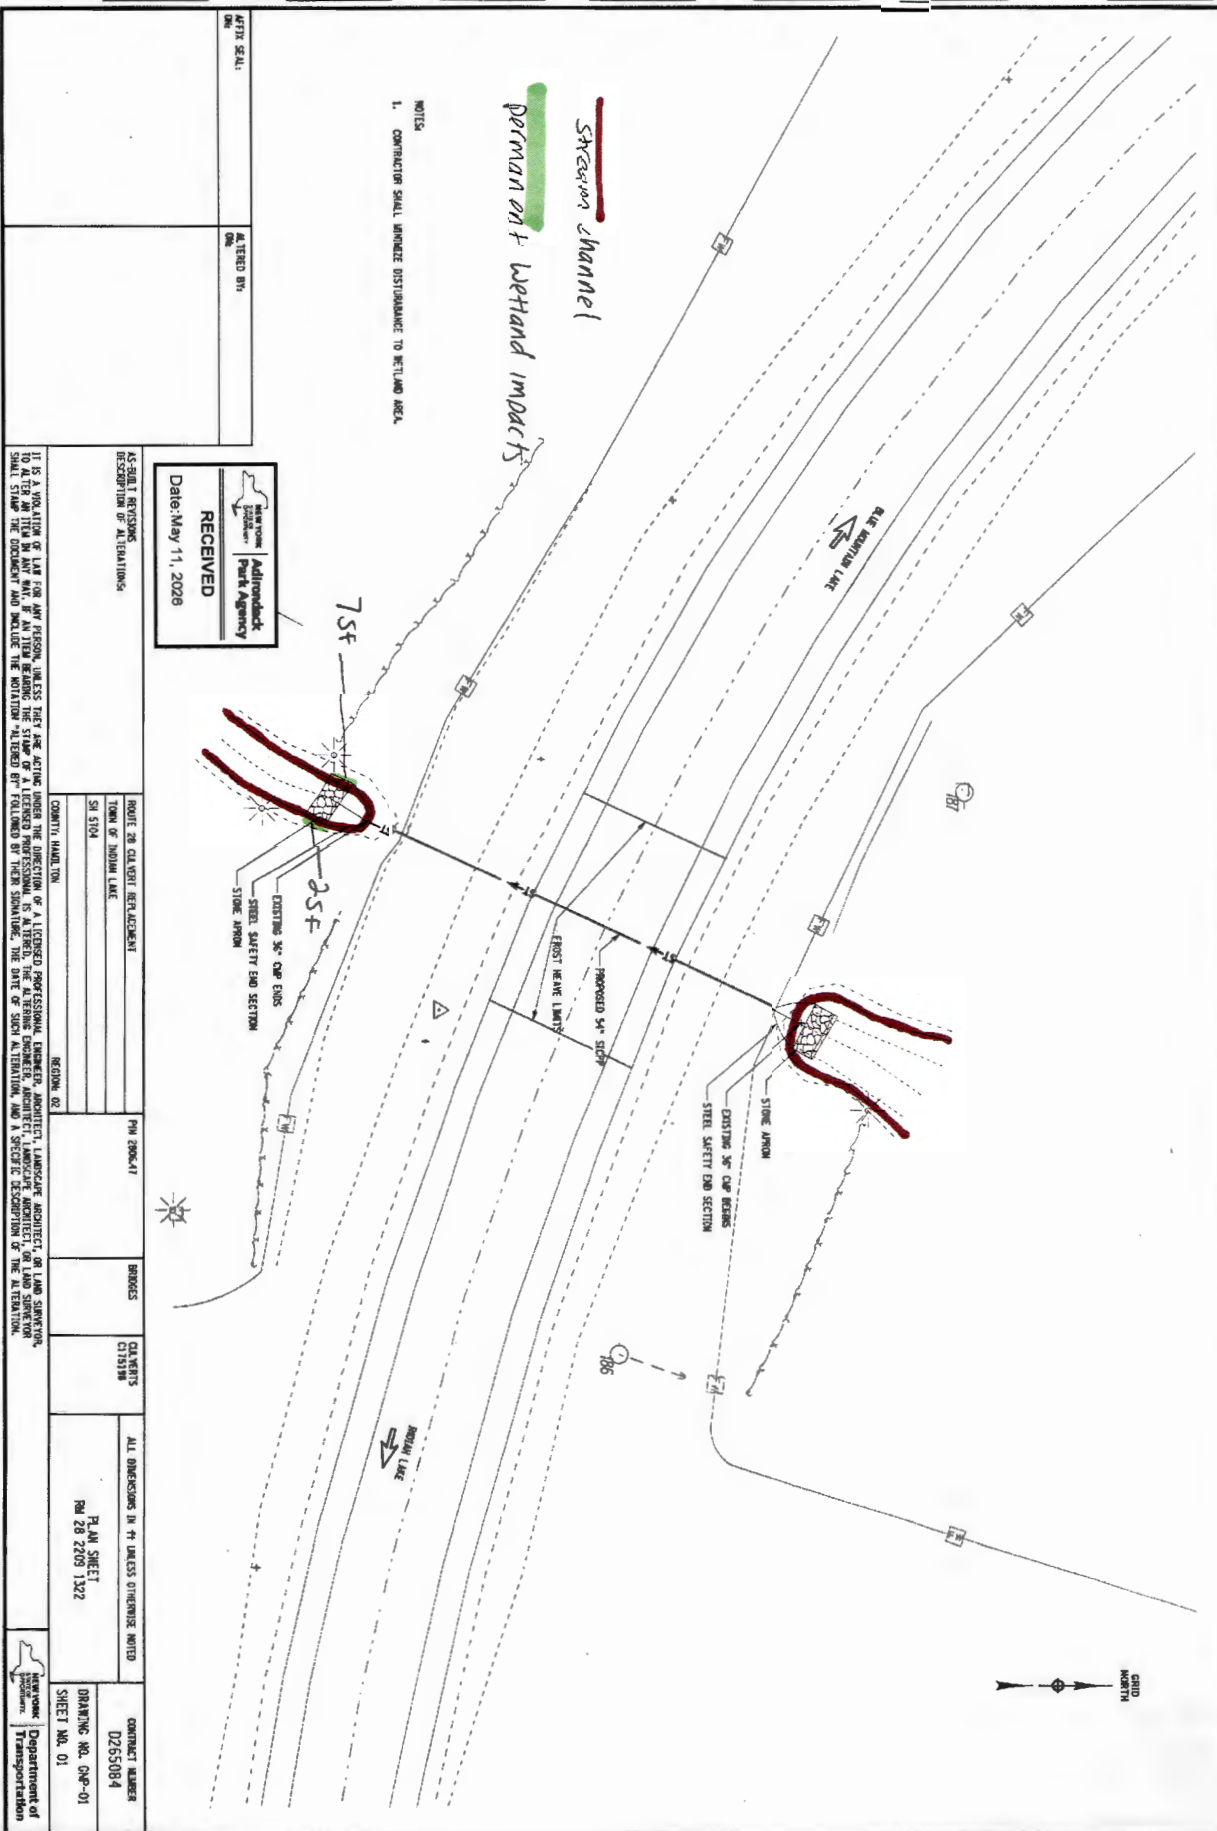

IT IS A VIOLATION OF LAW FOR ANY PERSON, UNLESS THEY ARE ACTING UNDER THE DIRECTION OF A LICENSED PROFESSIONAL ENGINEER, ARCHITECT, LANDSCAPE ARCHITECT, OR LAND SURVEYOR, TO ALTER OR ITEM IN ANY MANNER, BY ANY MEANS, INCLUDING THE STAMP OF A LICENSED PROFESSIONAL ENGINEER, ARCHITECT, LANDSCAPE ARCHITECT, OR LAND SURVEYOR, SHALL STAMP THE DOCUMENT AND INCLUDE THE NOTATION "ALTERED BY" FOLLOWED BY THEIR SIGNATURE, THE DATE OF SUCH ALTERATION, AND A SPECIFIC DESCRIPTION OF THE ALTERATION.

ROUTE 28 COLLETT REPLACEMENT
 TOWN OF INDIAN LAKE
 SN 5104

COUNTY, MAINT. DIV.

REGION, 02

PM 00041

BRIDGES

COUNTY'S

CT 1319W

ALL DIMENSIONS IN FT UNLESS OTHERWISE NOTED

PLAN SHEET

PA 28 2209 1322

CONTRACT NUMBER

D265084

DRAWING NO. ONE-01

SHEET NO. 01

Department of Transportation