

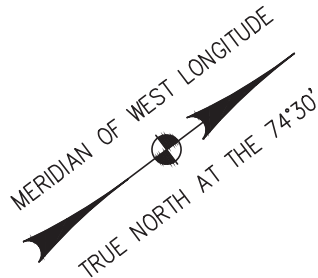


File Name: G:\MJ1075.21 Town of Jay - Salt Shed Survey\Cad\MJ1075.21 Town of Jay Salt Shed TOPO XSRVY.dwg (Layout: Layout1)
Date: Thu, Jul 16, 2026 - 9:13 AM (Name: jquinn)

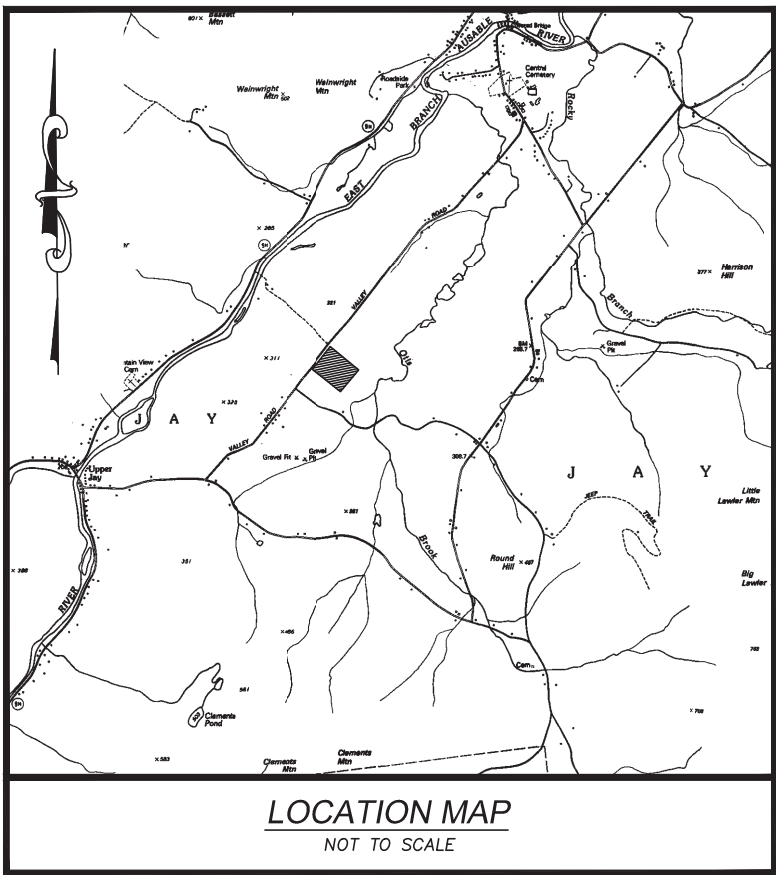


LEGEND	
	BENCHMARK
	UTILITY POLE
	UTILITY POLE WITH LIGHT
	DEAD UTILITY POLE
	GUY WIRE
	CONIFEROUS TREE
	SINGLE POST SIGN
	DOUBLE POST SIGN
	WOOD POST
	DRAINAGE INVERT
	ROCK
	BUILDING LINE
	SPOT ELEVATION
	MINOR CONTOUR
	MAJOR CONTOUR
	WOODS LINE
	CULVERT
	DITCH
	CHAIN LINK FENCE
	RAILING
	TAX PARCEL BOUNDARY
	APPROX. PROPERTY LINE

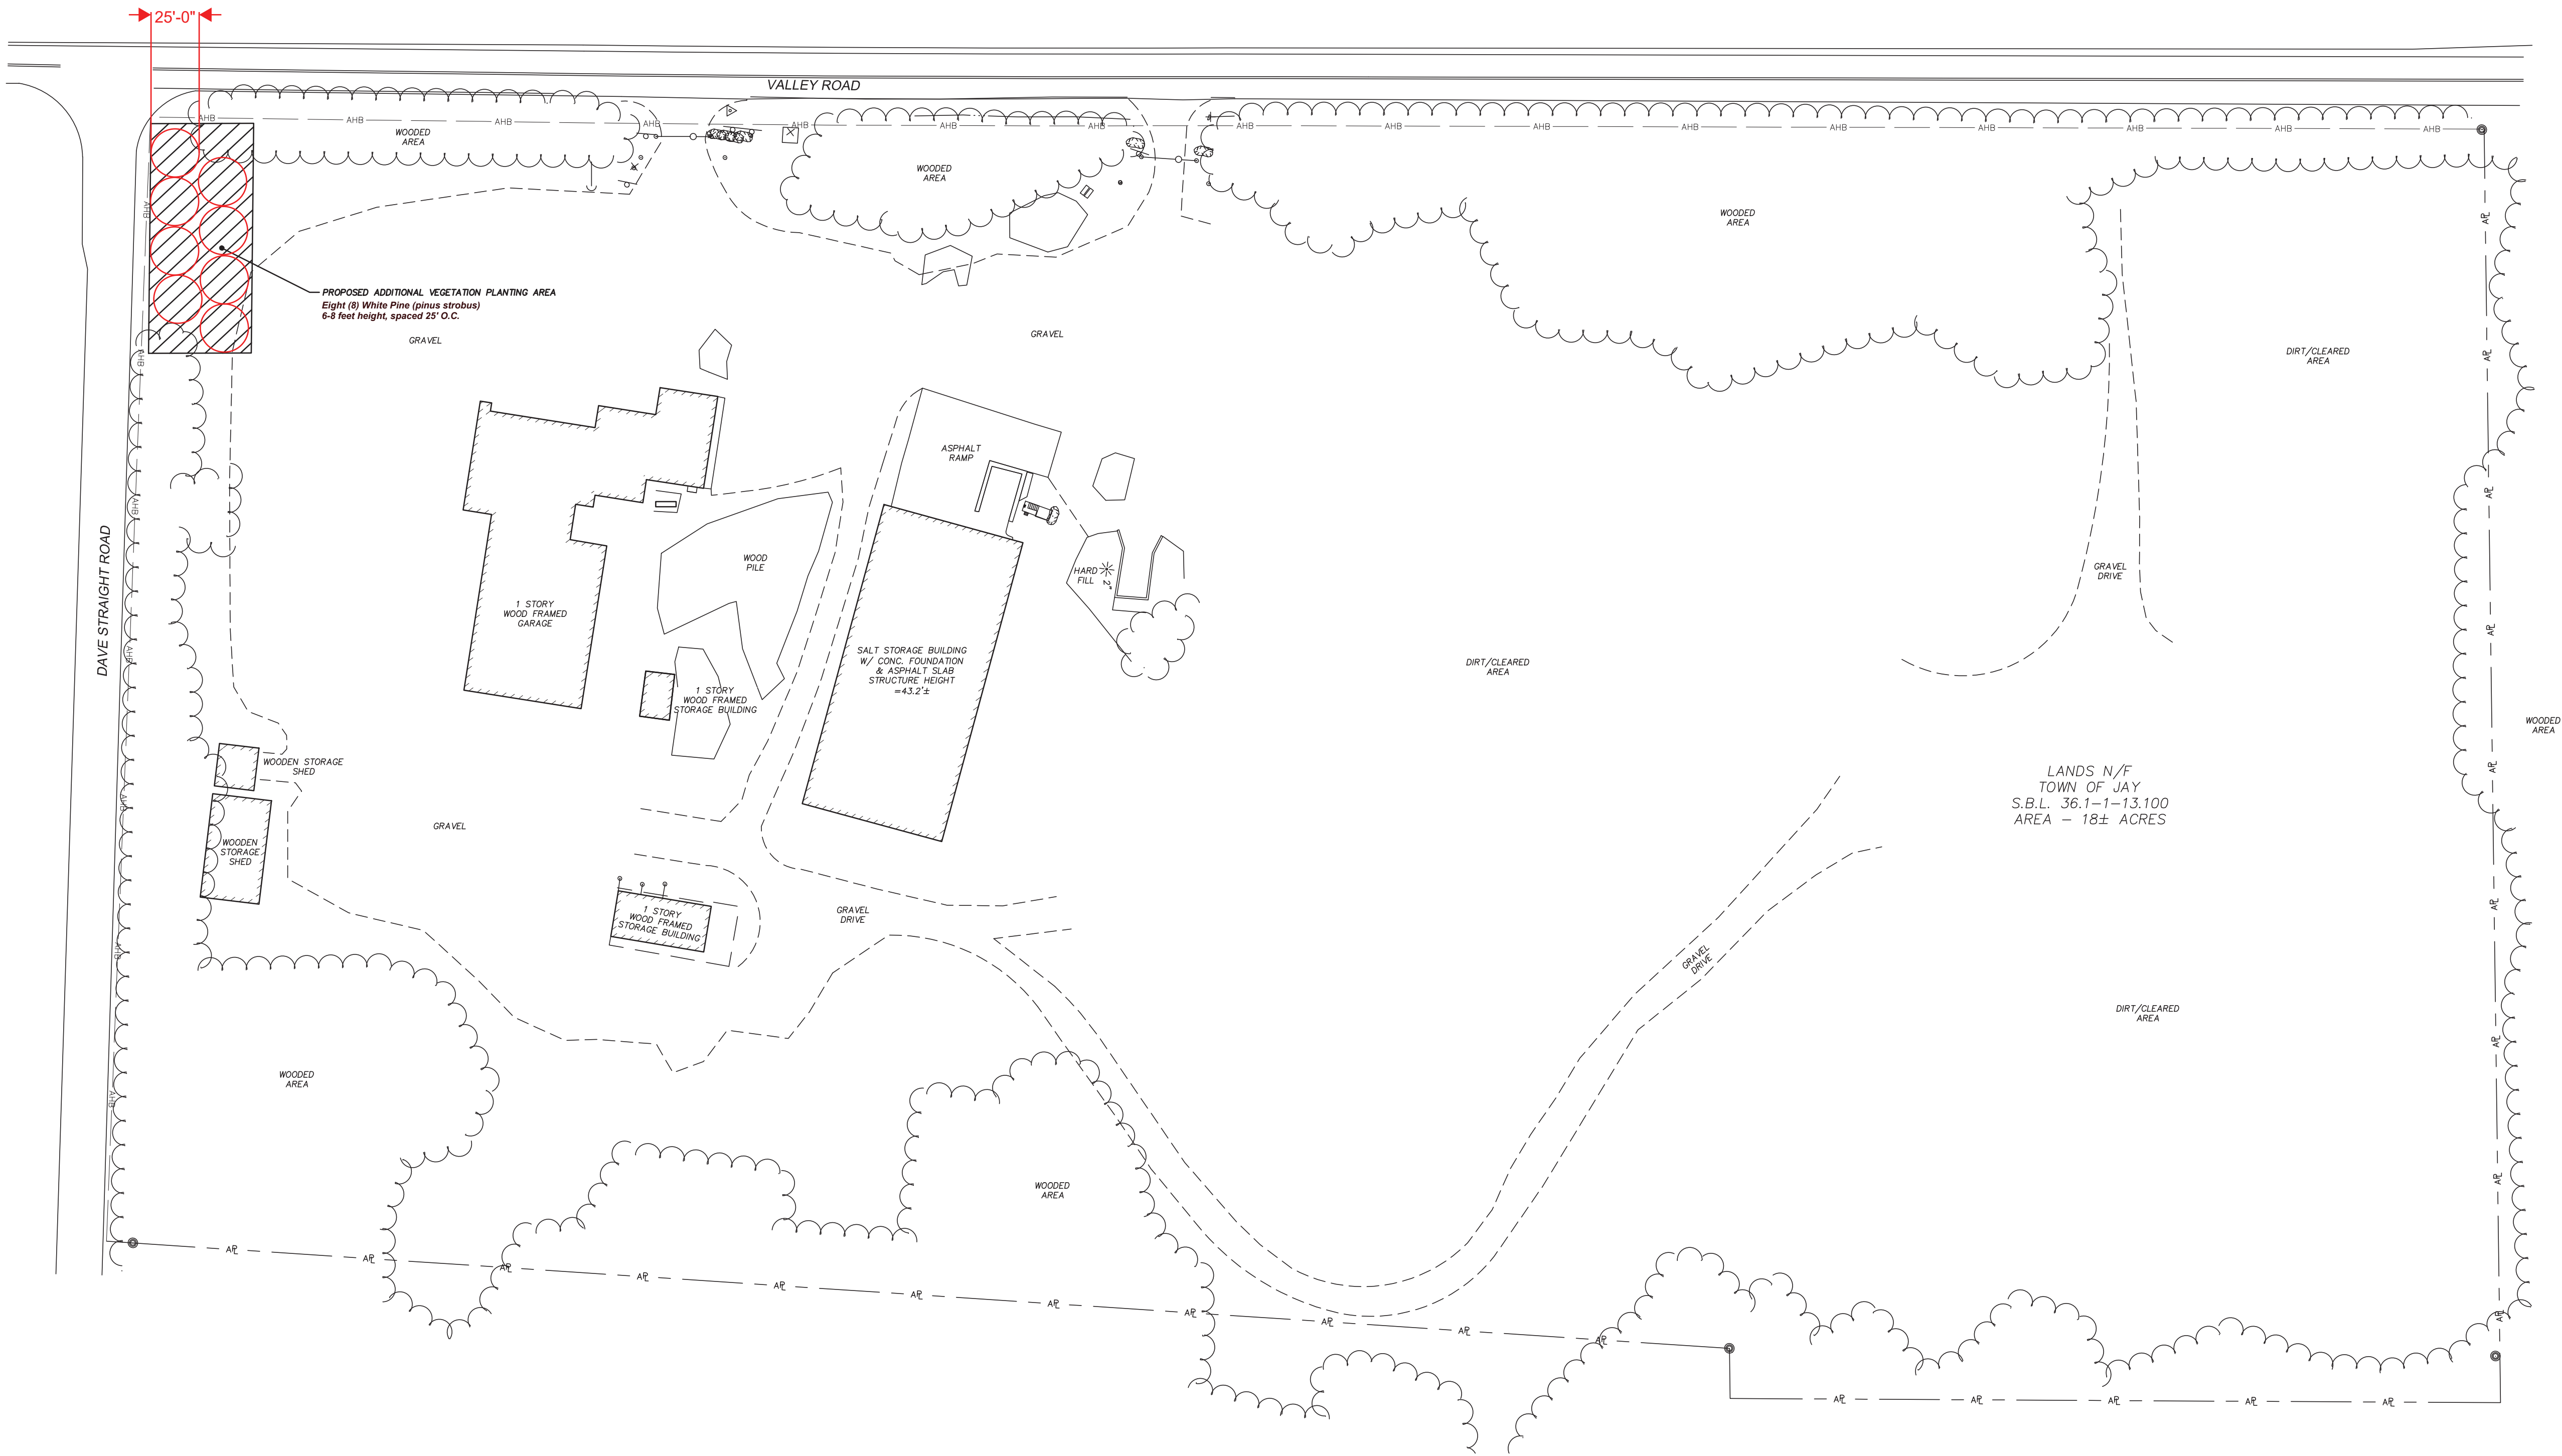

GENERAL NOTES:

- INFORMATION SHOWN HEREON IS FROM A FIELD SURVEY COMPLETED BY MJ ENGINEERING, ARCHITECTURE, LANDSCAPE ARCHITECTURE, AND LAND SURVEYING, P.C. ON MARCH 31, 2026, COMBINED WITH 2025 AERIAL IMAGERY.
- THE HORIZONTAL DATUM IS REFERENCED TO NORTH AMERICAN DATUM OF 1983 (NAD83/2011, EPOCH 2010.00), NEW YORK STATE PLANE EAST ZONE 3101.
- THE VERTICAL DATUM IS REFERENCED TO NORTH AMERICAN VERTICAL DATUM OF 1988 (NAVD88), GEOID18.
- CONTOUR INTERVAL = 1 FOOT.
- NORTH IS ORIENTED TO GRID NORTH FROM GPS OBSERVATION.
- UNDERGROUND UTILITIES SHOWN HEREON ARE BASED ON SURFACE EVIDENCE AND INFORMATION RECORDED DURING CONVENTIONAL SURVEY METHODS. THIS MAPPING DOES NOT PURPORT TO SHOW ALL UNDERGROUND UTILITIES ON SITE AND IS SUBJECT TO FIELD VERIFICATION.
- PROPERTY LINES SHOWN HEREON ARE APPROXIMATIONS ONLY BASED ON AVAILABLE DATA AND TAX MAPS FROM ESSEX COUNTY REAL PROPERTY TAX SERVICES AND ARE NOT THE RESULTS OF A FULL BOUNDARY SURVEY.
- SUBJECT TO ANY RIGHTS, EASEMENTS, COVENANTS, OR RESTRICTIONS OF RECORD.
- UNAUTHORIZED ALTERATION OR ADDITION TO A SURVEY MAP BEARING A LICENSED LAND SURVEYOR'S SEAL IS A VIOLATION OF SECTION 7209, SUB-DIVISION 2, OF THE NEW YORK STATE EDUCATION LAW. COPIES OF THIS SURVEY MAP NOT BEARING THE LAND SURVEYOR'S SEAL AND SIGNATURE SHALL NOT BE CONSIDERED TO BE VALID COPIES.

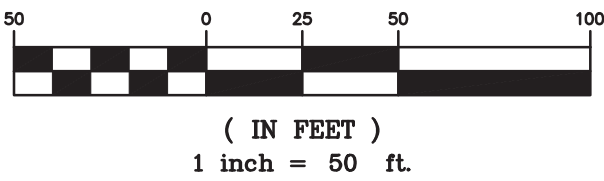

SUBMITTAL / REVISIONS					
No.	DATE	DESCRIPTION	BY	REVIEWED BY:	DATE
1	7/15/2026	APA COMMENTS ADDRESSED	BPM	JEQ	7/15/26
-					
-					
PROJ. MANAGER:	JEQ
CHIEF DESIGNER:	
DESIGNED BY:	
DRAWN BY:	MDL
CHECKED BY:	JGM



SEAL

SEAL

THE ALTERATION OF THIS MATERIAL IN ANY WAY, UNLESS DONE UNDER THE DIRECTION OF A COMPARABLE PROFESSIONAL LAND SURVEYOR FOR A LAND SURVEYOR, IS A VIOLATION OF THE NEW YORK STATE EDUCATION LAW AND/OR REGULATIONS AND IS A CLASS "A" MISDEMEANOR.




Engineering,
Architecture,
Landscape Architecture,
and Land Surveying, P.C.
21 Corporate Dr., Clifton Park, NY 12065
(518) 371-0799 • mjteam.com



SITE PLAN	
TOWN OF JAY SALT STORAGE FACILITY	
168 VALLEY RD ESSEX COUNTY	TOWN OF JAY NEW YORK
PREPARED FOR TOWN OF JAY	

SCALE: 1" = 50'
CONTRACT No.:
MJ PROJ. No.: MJ1075.21
DATE: 04/21/2026

1 OF 2

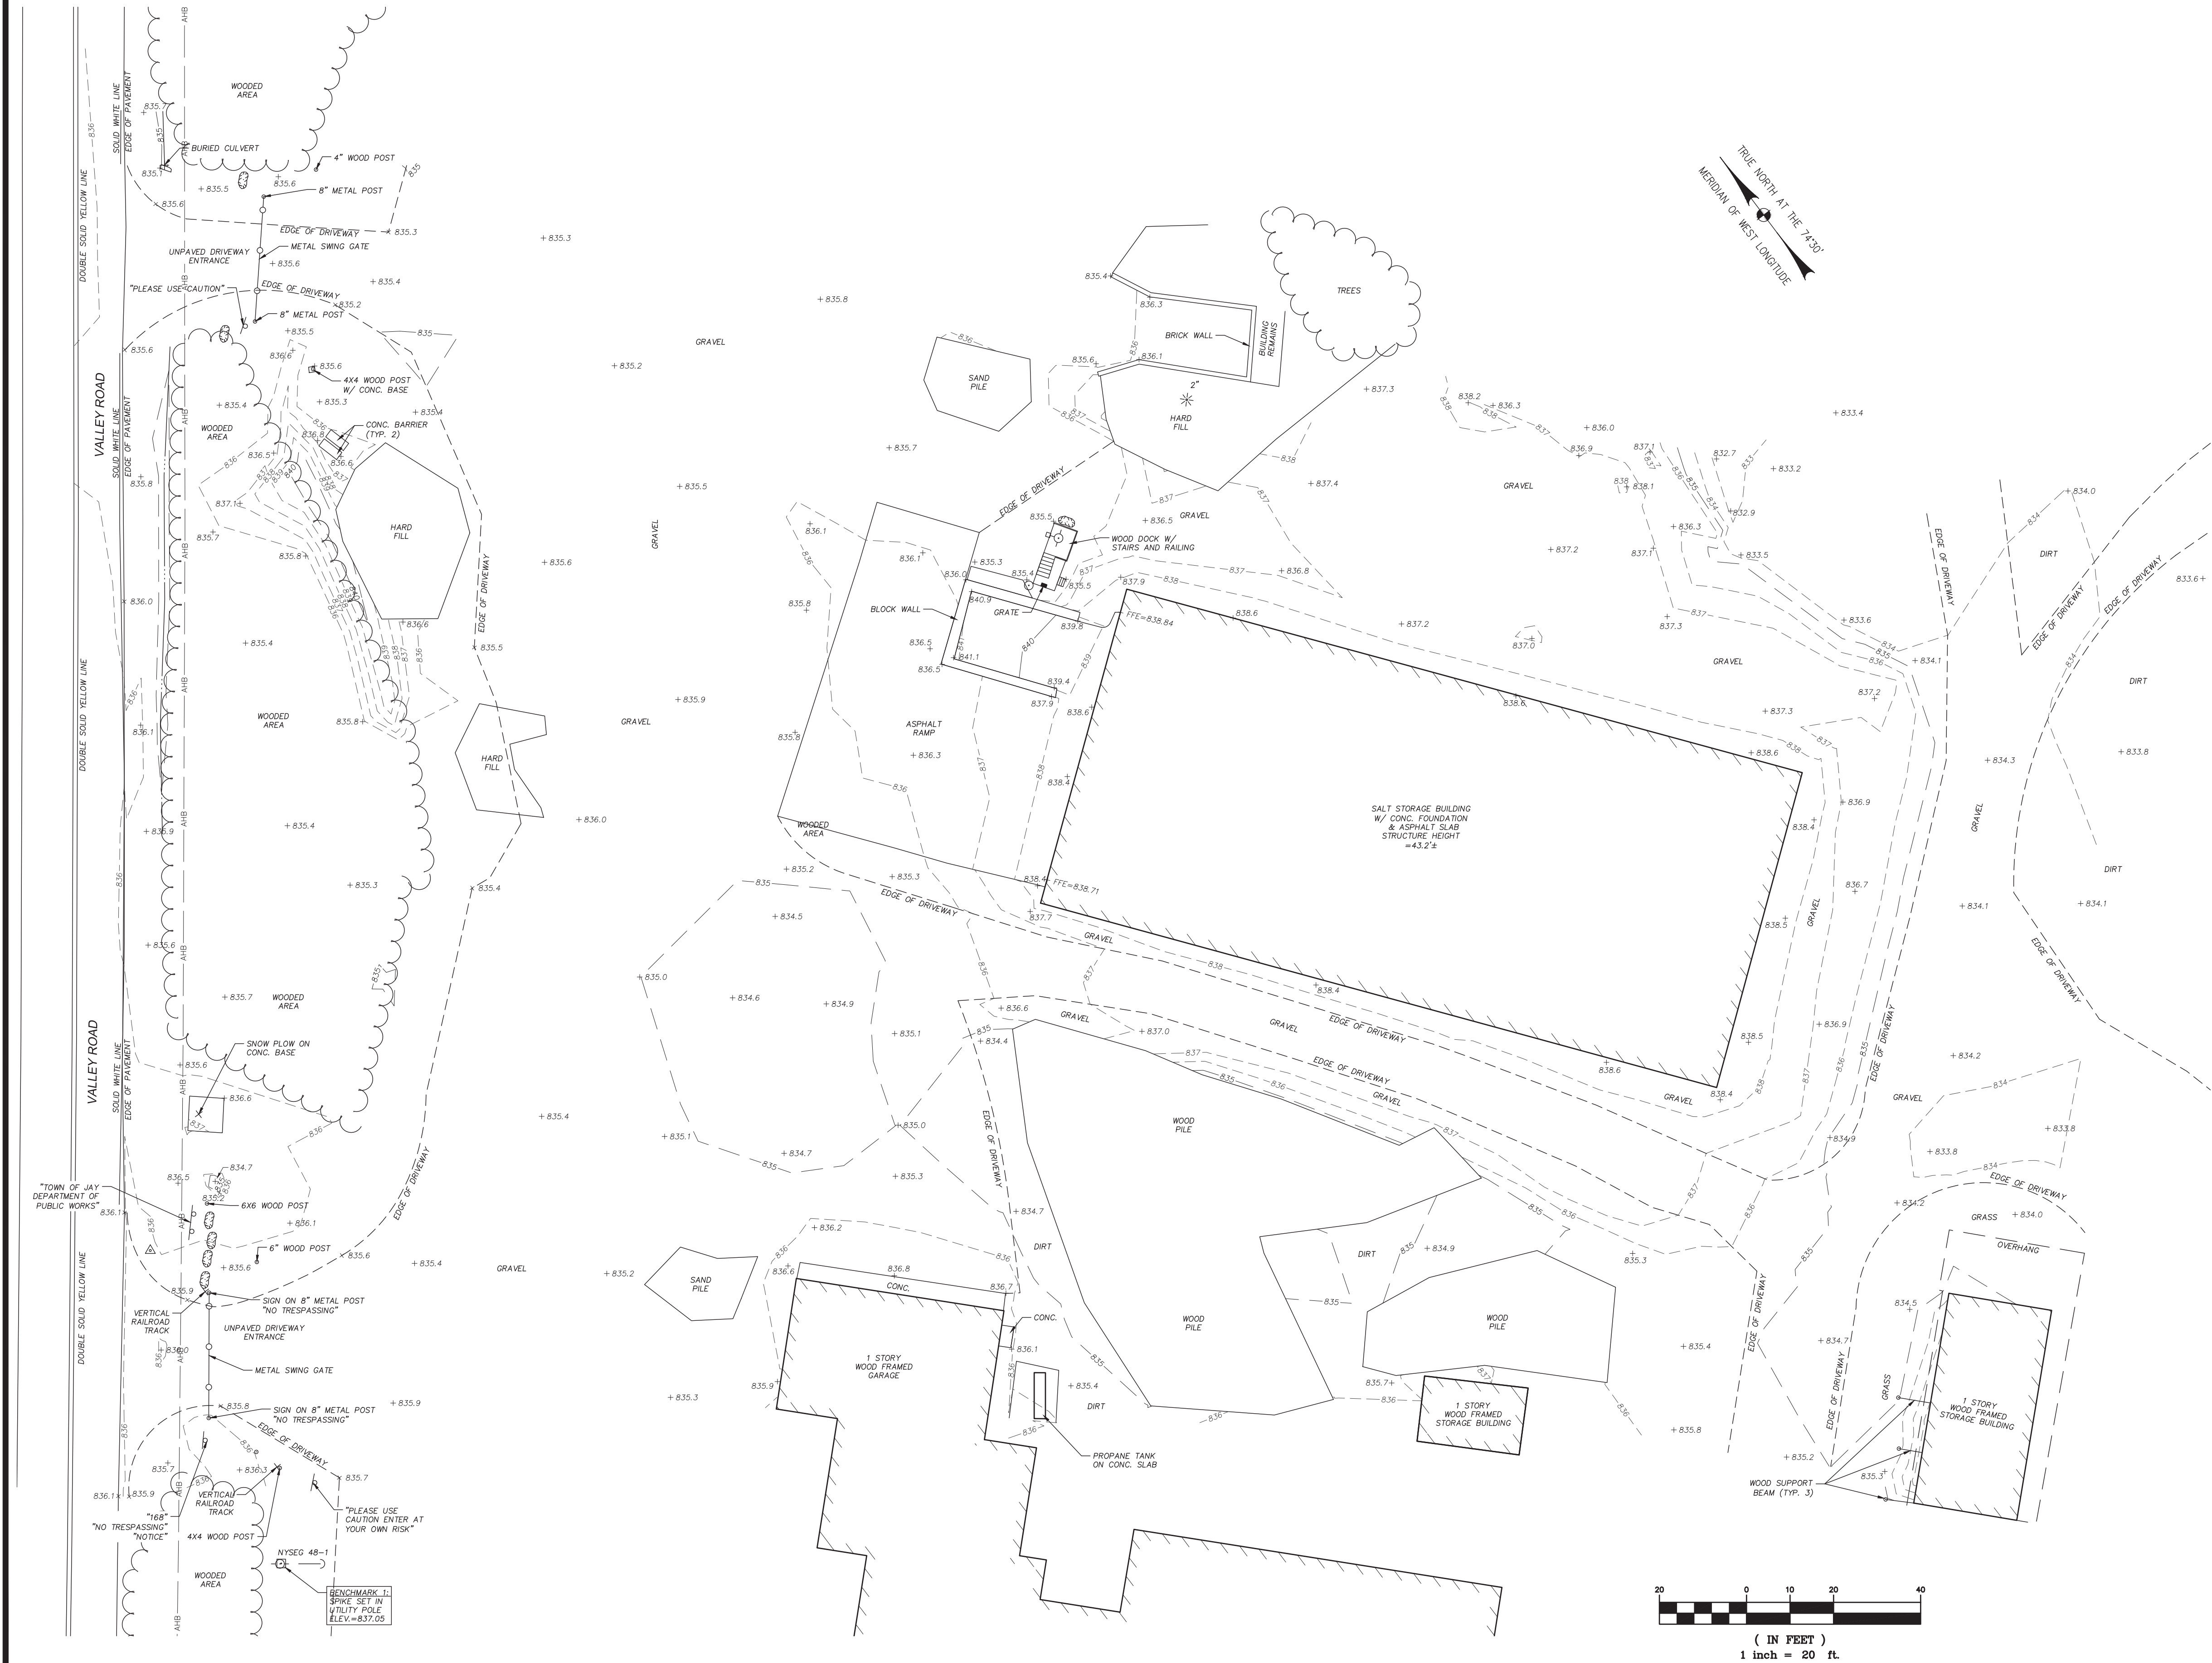


LEGEND	
	BENCHMARK
	UTILITY POLE
	UTILITY POLE WITH LIGHT
	DEAD UTILITY POLE
	GUY WIRE
	CONIFEROUS TREE
	SINGLE POST SIGN
	DOUBLE POST SIGN
	WOOD POST
	DRAINAGE INVERT
	ROCK
	BUILDING LINE
	SPOT ELEVATION
	MINOR CONTOUR
	MAJOR CONTOUR
	WOODS LINE
	CULVERT
	DITCH
	CHAIN LINK FENCE
	RAILING
	TAX PARCEL BOUNDARY
	APPROX. PROPERTY LINE

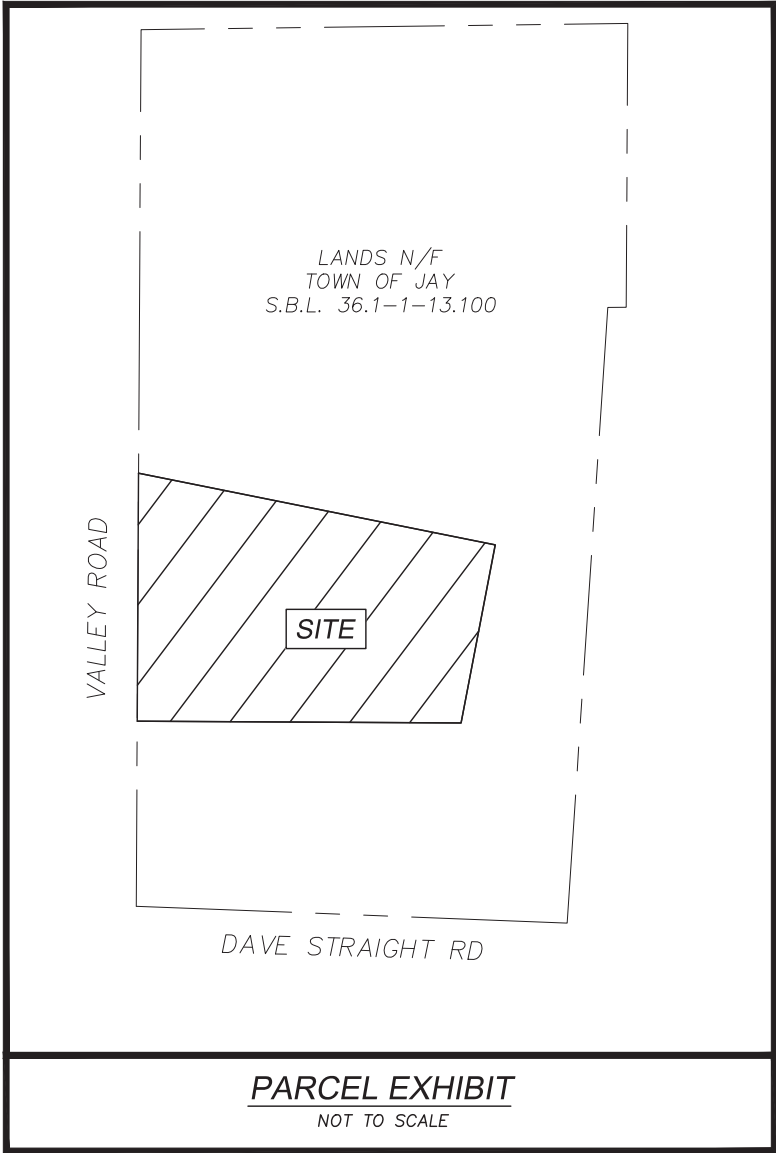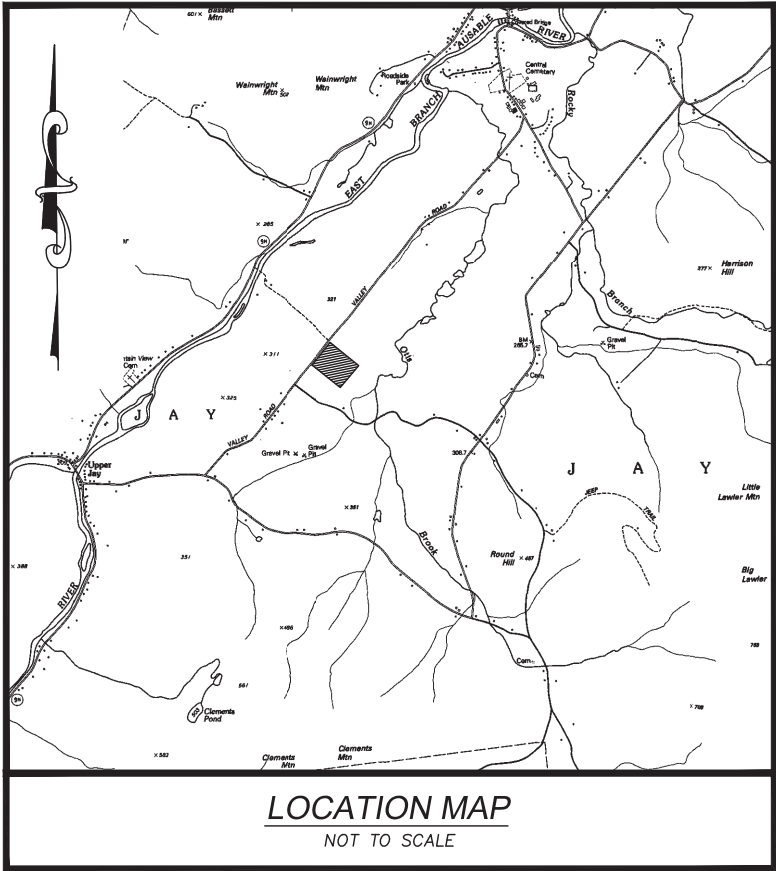

- GENERAL NOTES:**
- INFORMATION SHOWN HEREON IS FROM A FIELD SURVEY COMPLETED BY MJ ENGINEERING, ARCHITECTURE, LANDSCAPE ARCHITECTURE, AND LAND SURVEYING, P.C. ON MARCH 31, 2026, COMBINED WITH 2025 AERIAL IMAGERY.
 - THE HORIZONTAL DATUM IS REFERENCED TO NORTH AMERICAN DATUM OF 1983 (NAD83/2011, EPOCH 2010.00), NEW YORK STATE PLANE EAST ZONE 3101.
 - THE VERTICAL DATUM IS REFERENCED TO NORTH AMERICAN VERTICAL DATUM OF 1988 (NAVD88), GEOID18.
 - CONTOUR INTERVAL = 1 FOOT.
 - NORTH IS ORIENTED TO GRID NORTH FROM GPS OBSERVATION.
 - UNDERGROUND UTILITIES SHOWN HEREON ARE BASED ON SURFACE EVIDENCE AND INFORMATION RECORDED DURING CONVENTIONAL SURVEY METHODS. THIS MAPPING DOES NOT PURPORT TO SHOW ALL UNDERGROUND UTILITIES ON SITE AND IS SUBJECT TO FIELD VERIFICATION.
 - PROPERTY LINES SHOWN HEREON ARE APPROXIMATIONS ONLY BASED ON AVAILABLE DATA AND TAX MAPS FROM ESSEX COUNTY REAL PROPERTY TAX SERVICES AND ARE NOT THE RESULTS OF A FULL BOUNDARY SURVEY.
 - SUBJECT TO ANY RIGHTS, EASEMENTS, COVENANTS, OR RESTRICTIONS OF RECORD.
 - UNAUTHORIZED ALTERATION OR ADDITION TO A SURVEY MAP BEARING A LICENSED LAND SURVEYOR'S SEAL IS A VIOLATION OF SECTION 7209, SUB-DIVISION 2, OF THE NEW YORK STATE EDUCATION LAW. COPIES OF THIS SURVEY MAP NOT BEARING THE LAND SURVEYORS SEAL AND SIGNATURE SHALL NOT BE CONSIDERED TO BE VALID COPIES.

SUBMITTAL / REVISIONS				
No.	DATE	DESCRIPTION	BY	REVIEWED BY: DATE
1	7/15/2026	APA COMMENTS ADDRESSED	BPM	JEQ 7/15/26

PROJ. MANAGER: JEQ
CHIEF DESIGNER:
DESIGNED BY:
DRAWN BY: MDL
CHECKED BY: JGM

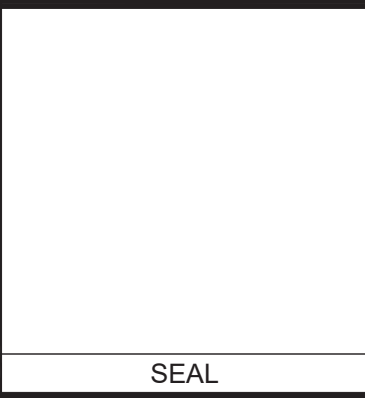

THE ALTERATION OF THIS MATERIAL IN ANY WAY, UNLESS DONE UNDER THE DIRECTION OF A COMPARABLE PROFESSIONAL LAND SURVEYOR FOR A LAND SURVEYOR, IS A VIOLATION OF THE NEW YORK STATE EDUCATION LAW AND/OR REGULATIONS AND IS A CLASS "A" MISDEMEANOR.

Engineering,
Architecture,
Landscape Architecture,
and Land Surveying, P.C.
21 Corporate Dr., Clifton Park, NY 12065
(518) 371-0799 • mjteam.com

AS-BUILT SURVEY

TOWN OF JAY

SALT STORAGE FACILITY

168 VALLEY RD
ESSEX COUNTY

TOWN OF JAY
NEW YORK

PREPARED FOR TOWN OF JAY

SCALE: 1" = 20'

CONTRACT No.: MJ PROJ. No.: MJ1075.21

DATE: 04/21/2026

2 OF 2